
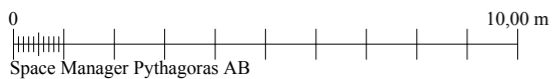


Ledig lokal

Ledig lokal (91m²) ■

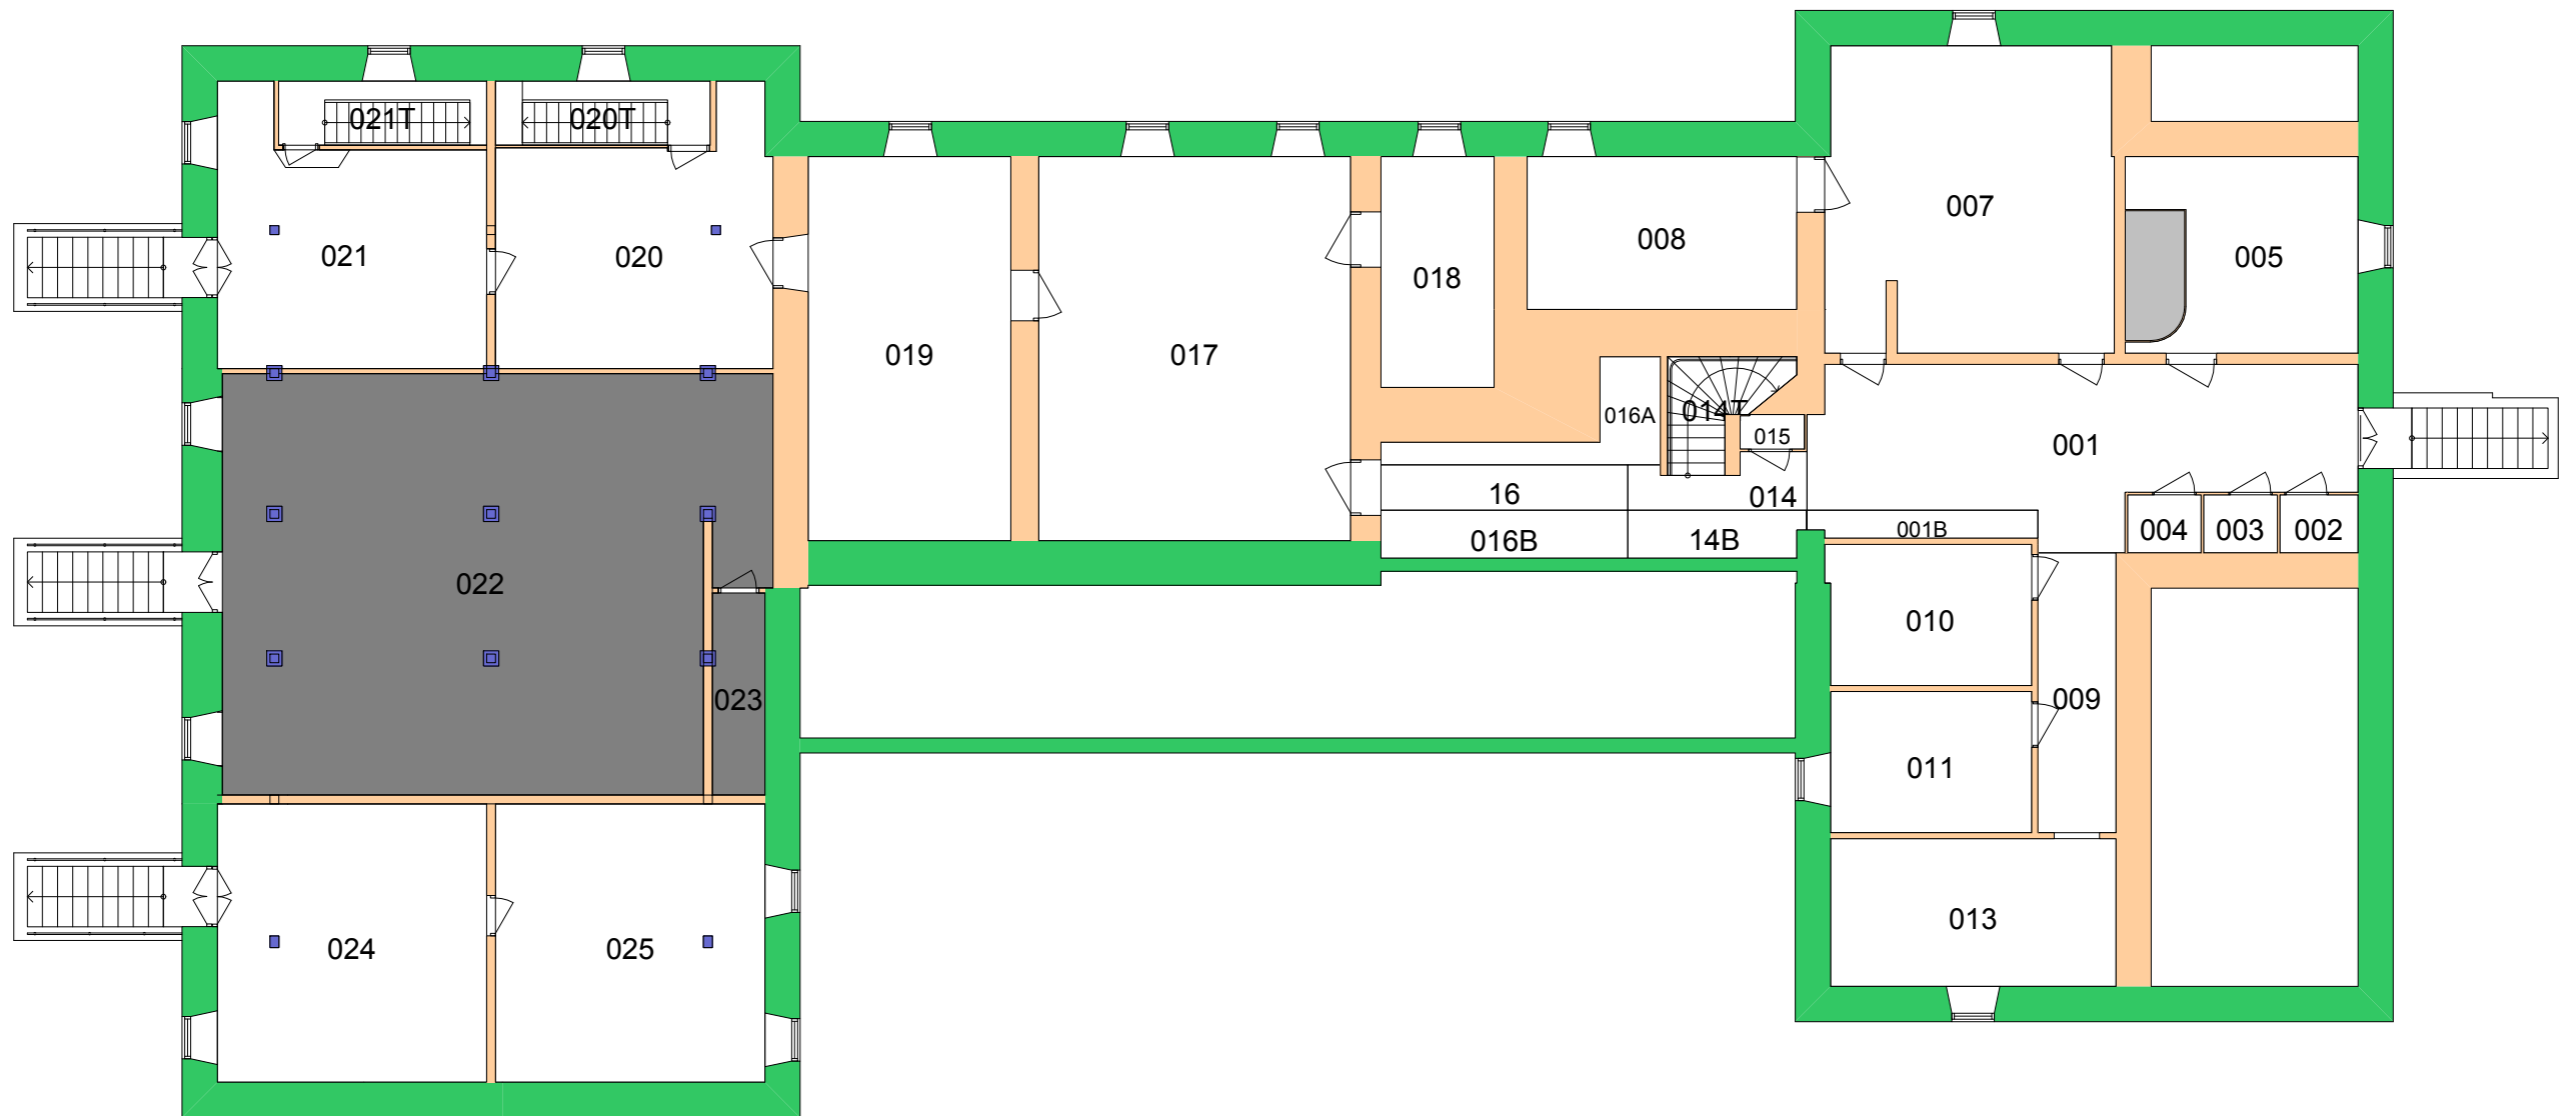

Space Manager Pythagoras AB

FÖRVALTNINGSHAND



Ledig lokal
KARLSBORGS FÄSTNING
R402050
Soldathemmet
Plar01

Skala: 1:150 Datum: 2021-02-19 Relationsritningsdatum: 2019-06-24

Del:1/1